


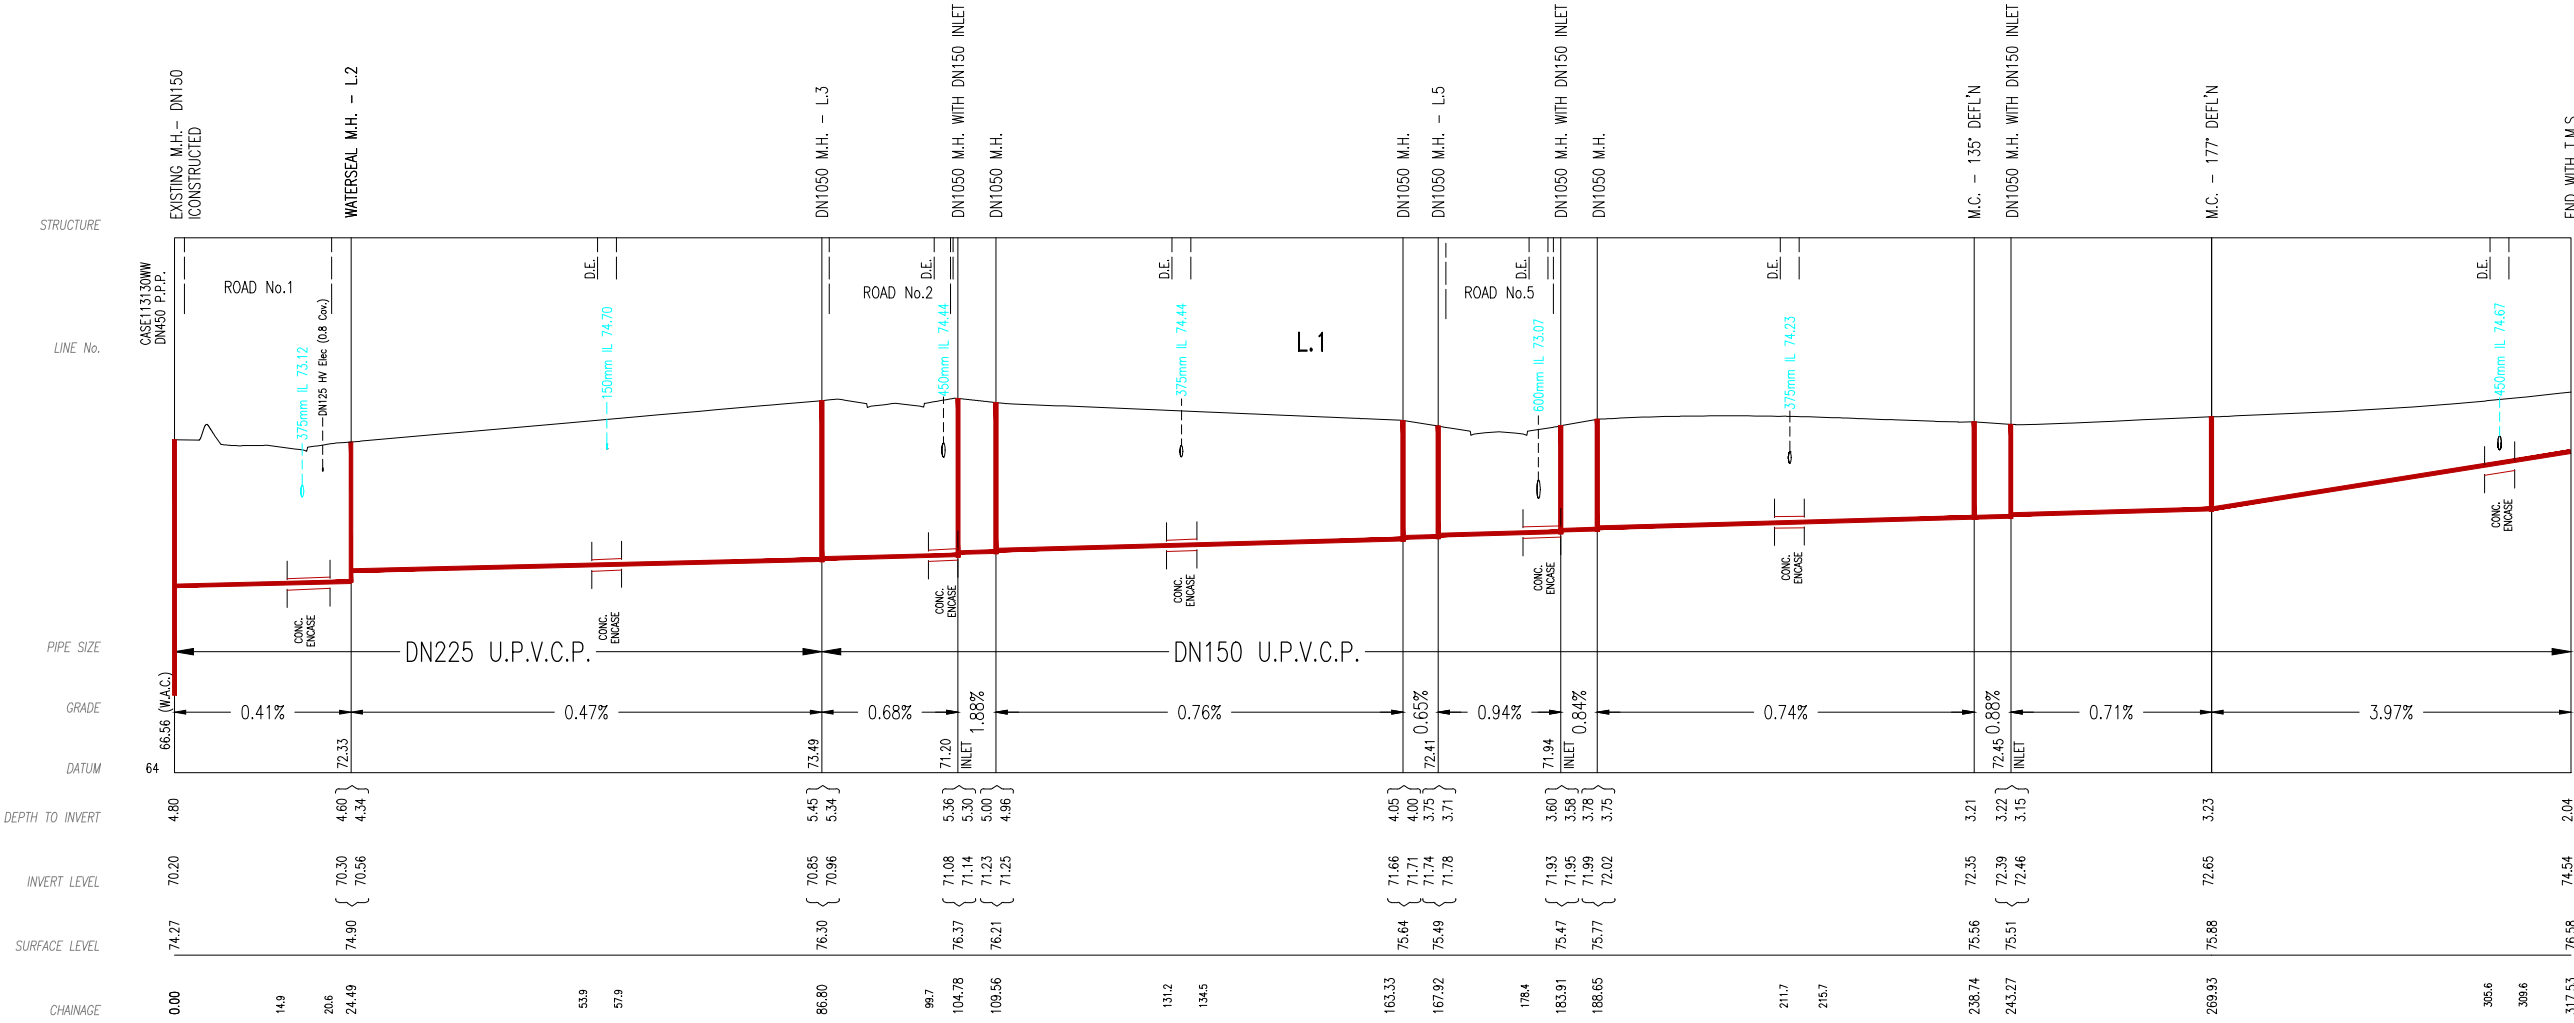

WORK AS CONSTRUCTED CERTIFICATION		Sydney WATER Case No. 201349WW SHT 4 OF 8 SHTS.	
DEVELOPER			
W.S.C.			
CONSTRUCTOR			
COMPLETED			
W.A.C. PREPARED			
DESIGNER		SYDNEY WATER CORPORATION	
I CERTIFY THAT THE WORKS HAVE BEEN CONSTRUCTED IN ACCORDANCE WITH THE WORK AS CONSTRUCTED DRAWINGS		FOR DETAILS OF SERVICES SEE SHEET 1	