



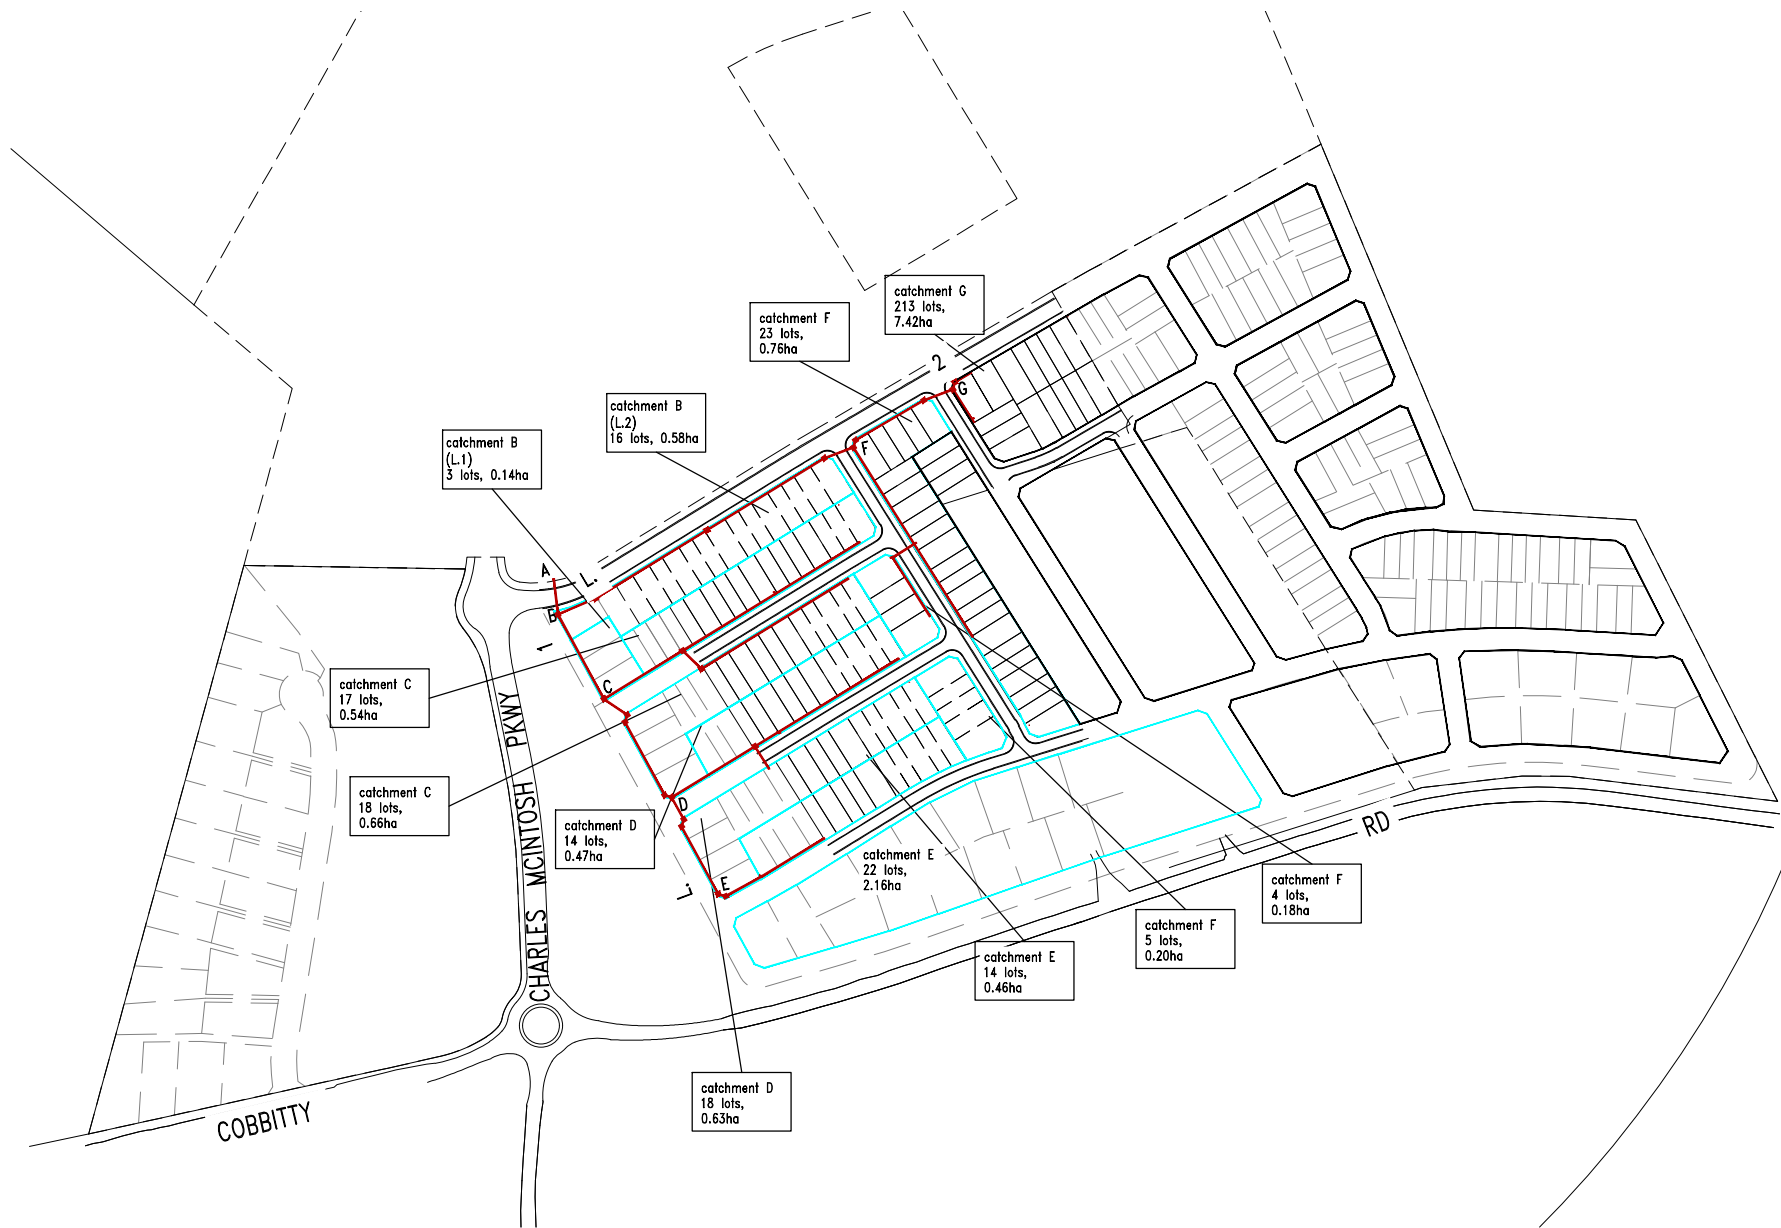

PROPOSED SEWER FLOW AND CAPACITY
(NOT TO SCALE)

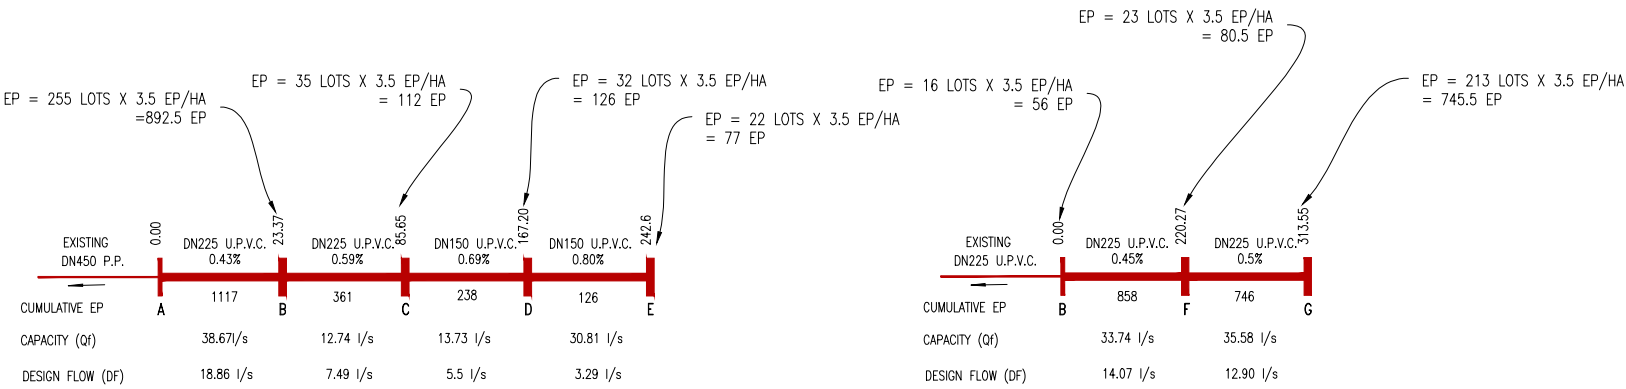

FLOW DIAGRAM – LINE 1
(NOT TO SCALE)

FLOW DIAGRAM – LINE 2
(NOT TO SCALE)

SEWERAGE FLOW SCHEDULE (SUMMARY) : Updated Jan 2016

Complied by:		P Patel		Date:		29.11.22							
Checked by:		F Jaehne		Date:		29.11.22							
Plan No.		EN30433		Location:		421 Cobbitty Rd Cobbitty		JOB No. (SWC use)				0	
e-Developer No		CASE201349		Description:		Sewer extension - L.1		00-Jan-00				0	

SUMMARY													
SECTION	CHAINAGE	TOTAL AREA	TOTAL Grav	TOTAL Grav + Pump	PIPE SIZE (DN)	PIPE SIZE (ID)	PIPE GRADE	DESIGN FLOW (DF)	Qf (Capacity)	Actual	SELF CLEANSING	SLIME CONTROL	Capacity
	m	Ha	EP	EP	mm	mm	%	L/s	L/s	PDPWF			Deficit
A	0.0	13.26	1204	1204	225	233.6	0.43	18.86	32.98	6.29	Self Cleansing OK	NA	OK
B	23.37	13.26	1204	1204	225	233.6	0.59	18.86	38.67	6.29	Self Cleansing OK	NA	OK
C	85.65	4.36	312	312	150	149.6	0.89	7.49	12.74	2.50	Self Cleansing OK	NA	OK
D	167.20	3.26	189	189	150	149.6	0.8	5.50	13.73	1.83	Self Cleansing OK	NA	OK
E	242.6	2.16	77	77	150	149.6	4	3.29	30.81	1.10	Self Cleansing OK	NA	OK

SEWERAGE FLOW SCHEDULE (SUMMARY) : Updated Jan 2016

Complied by:		P Patel	Date:		29.11.22									
Checked by:		F Jaehne	Date:		29.11.22									
Plan No.		EN303433		Location:		421 Cobbitty Rd Cobbitty		JOB No. (SWC use)		0				
e-Developer No		CASE201349		Description:		Sewer extension - L.2		00-Jan-00		0				

SUMMARY													
SECTION	CHAINAGE	TOTAL AREA	TOTAL Grav	TOTAL Grav + Pump	PIPE SIZE (DN)	PIPE SIZE (ID)	PIPE GRADE	DESIGN FLOW (DF)	Qf (Capacity)	Actual	SELF CLEANSING	SLIME CONTROL	Capacity
	m	Ha	EP	EP	mm	mm	%	L/s	L/s	PDWF			Deficit
POINT B	0	4.52	882	882	225	233.6	0.43	14.78	32.98	5.24	Self Cleansing OK	NA	OK
F	220.27	3.94	826	826	225	233.6	0.45	14.07	33.74	5.03	Self Cleansing OK	NA	OK
G	313.55	2.8	746	746	225	233.6	0.5	12.90	35.58	4.79	Self Cleansing OK	NA	OK

WORK AS CONSTRUCTED CERTIFICATION	Sydney WATER	SYDNEY WATER CORPORATION
DEVELOPER	W.S.C.	CONSTRUCTOR
COMPLETED	W.A.C. PREPARED	DESIGNER
I CERTIFY THAT THE WORKS HAVE BEEN CONSTRUCTED IN ACCORDANCE WITH THE WORK AS CONSTRUCTED DRAWINGS		FOR DETAILS OF SERVICES SEE SHEET 1