
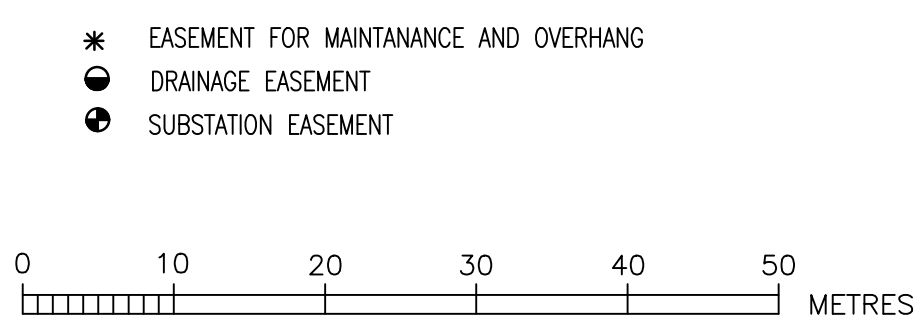
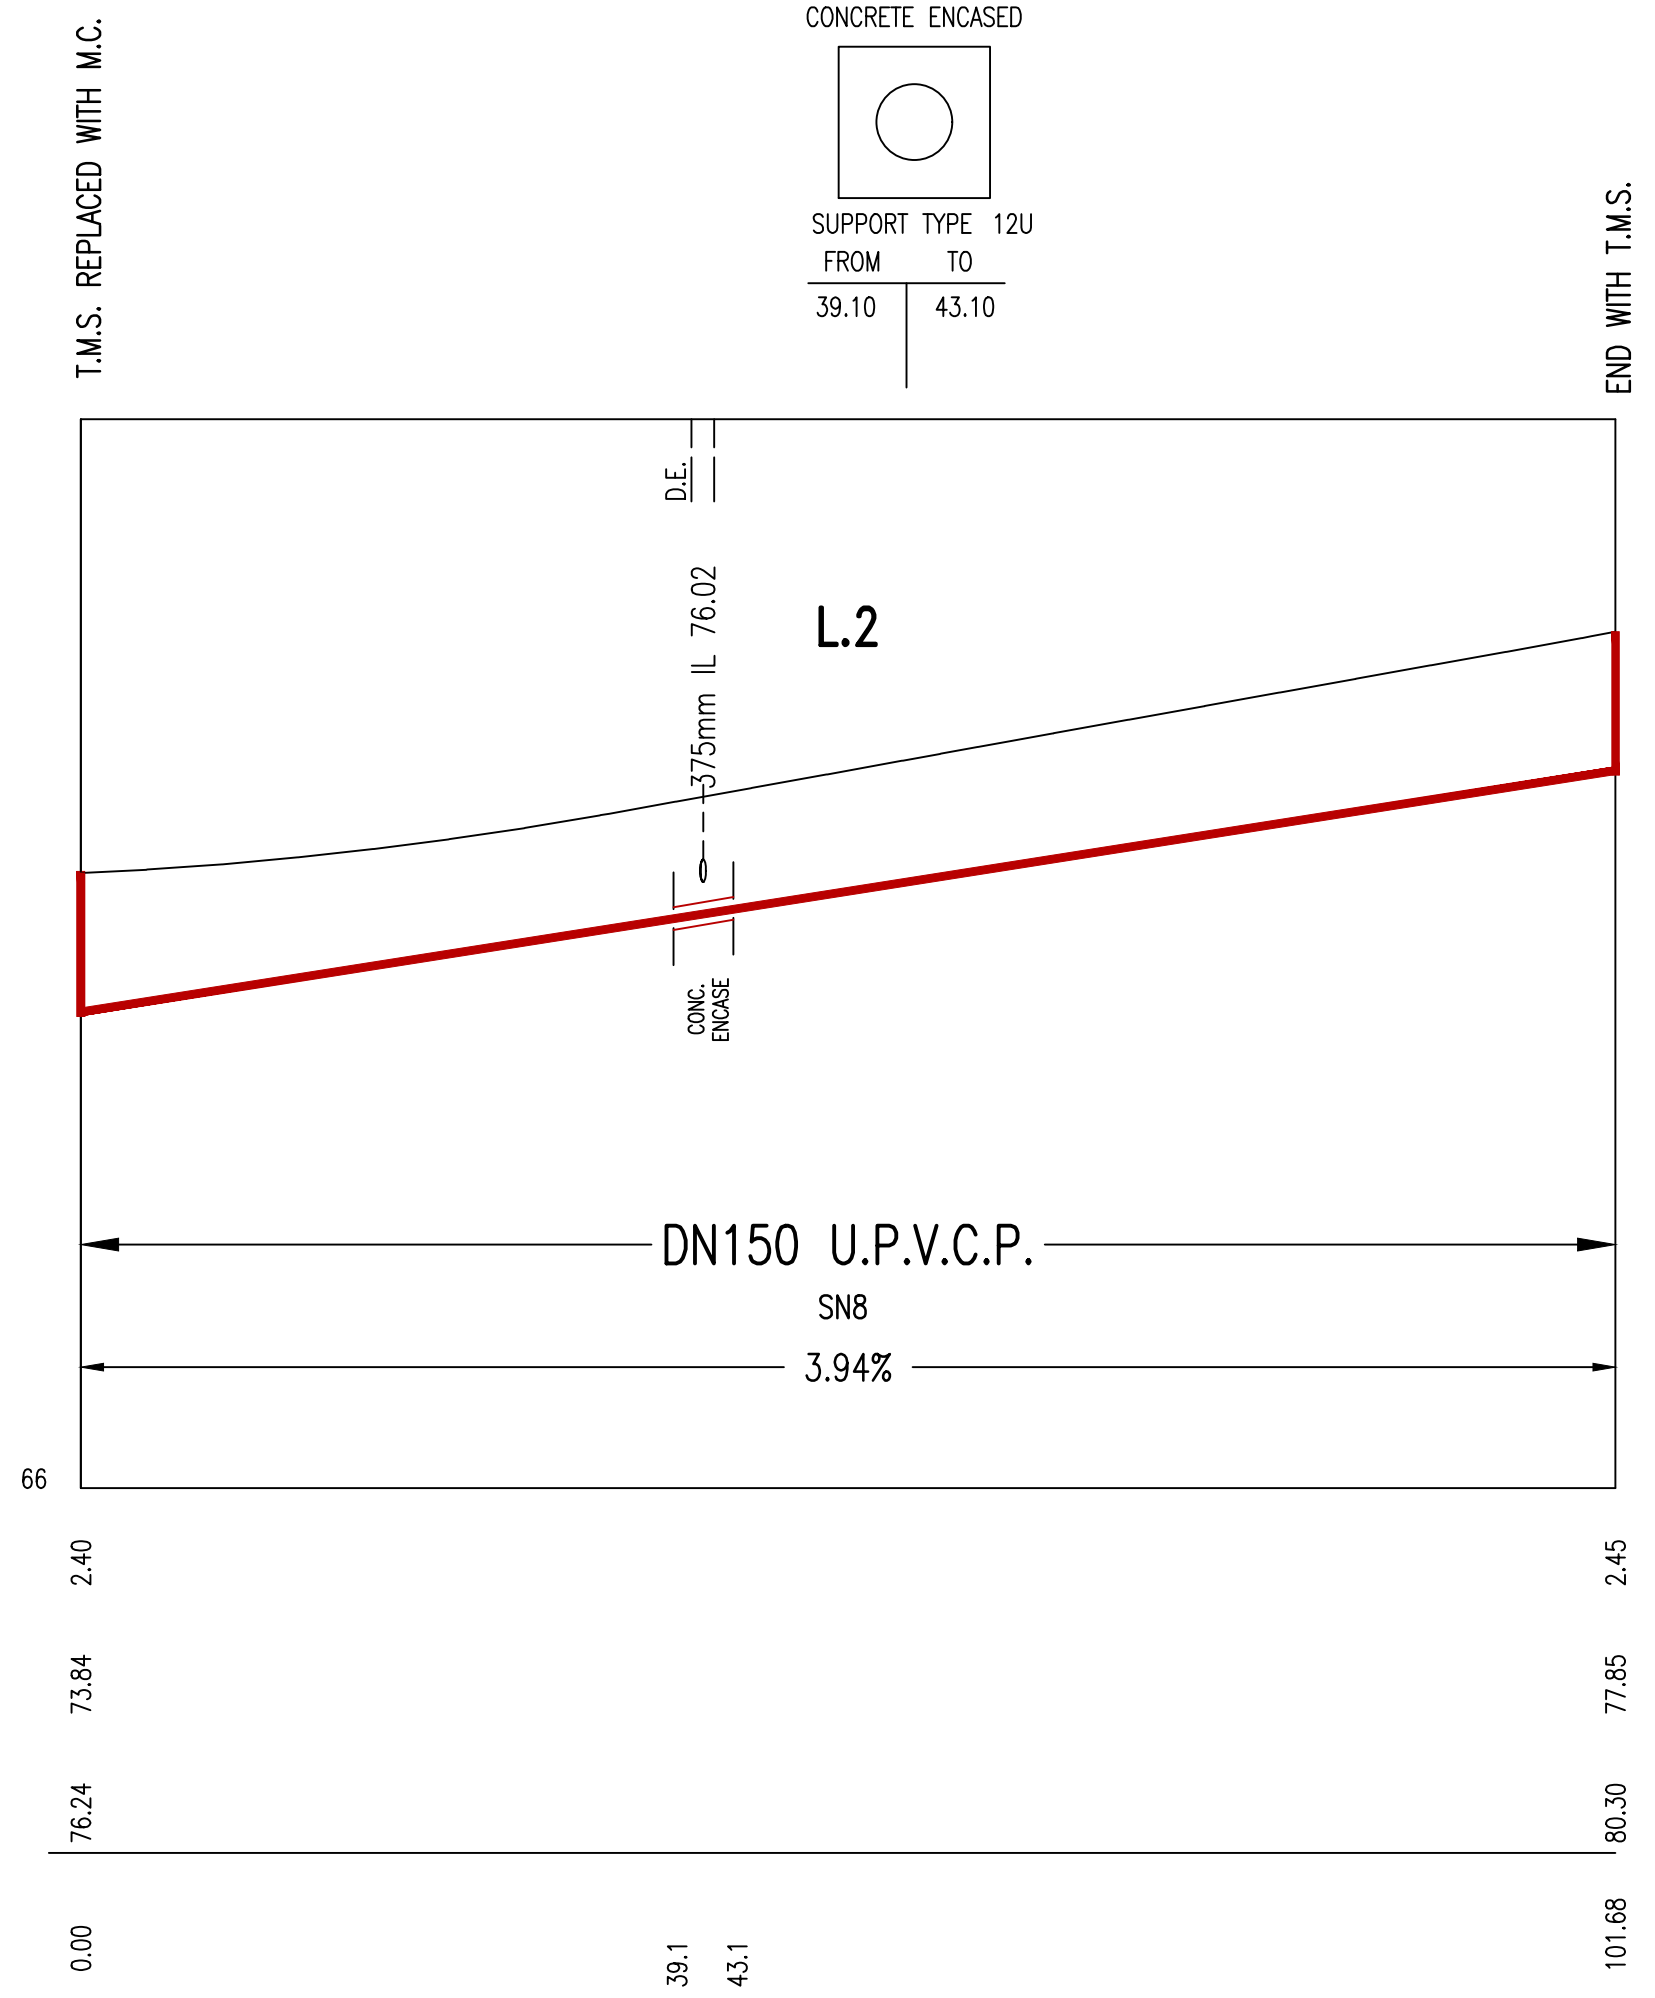
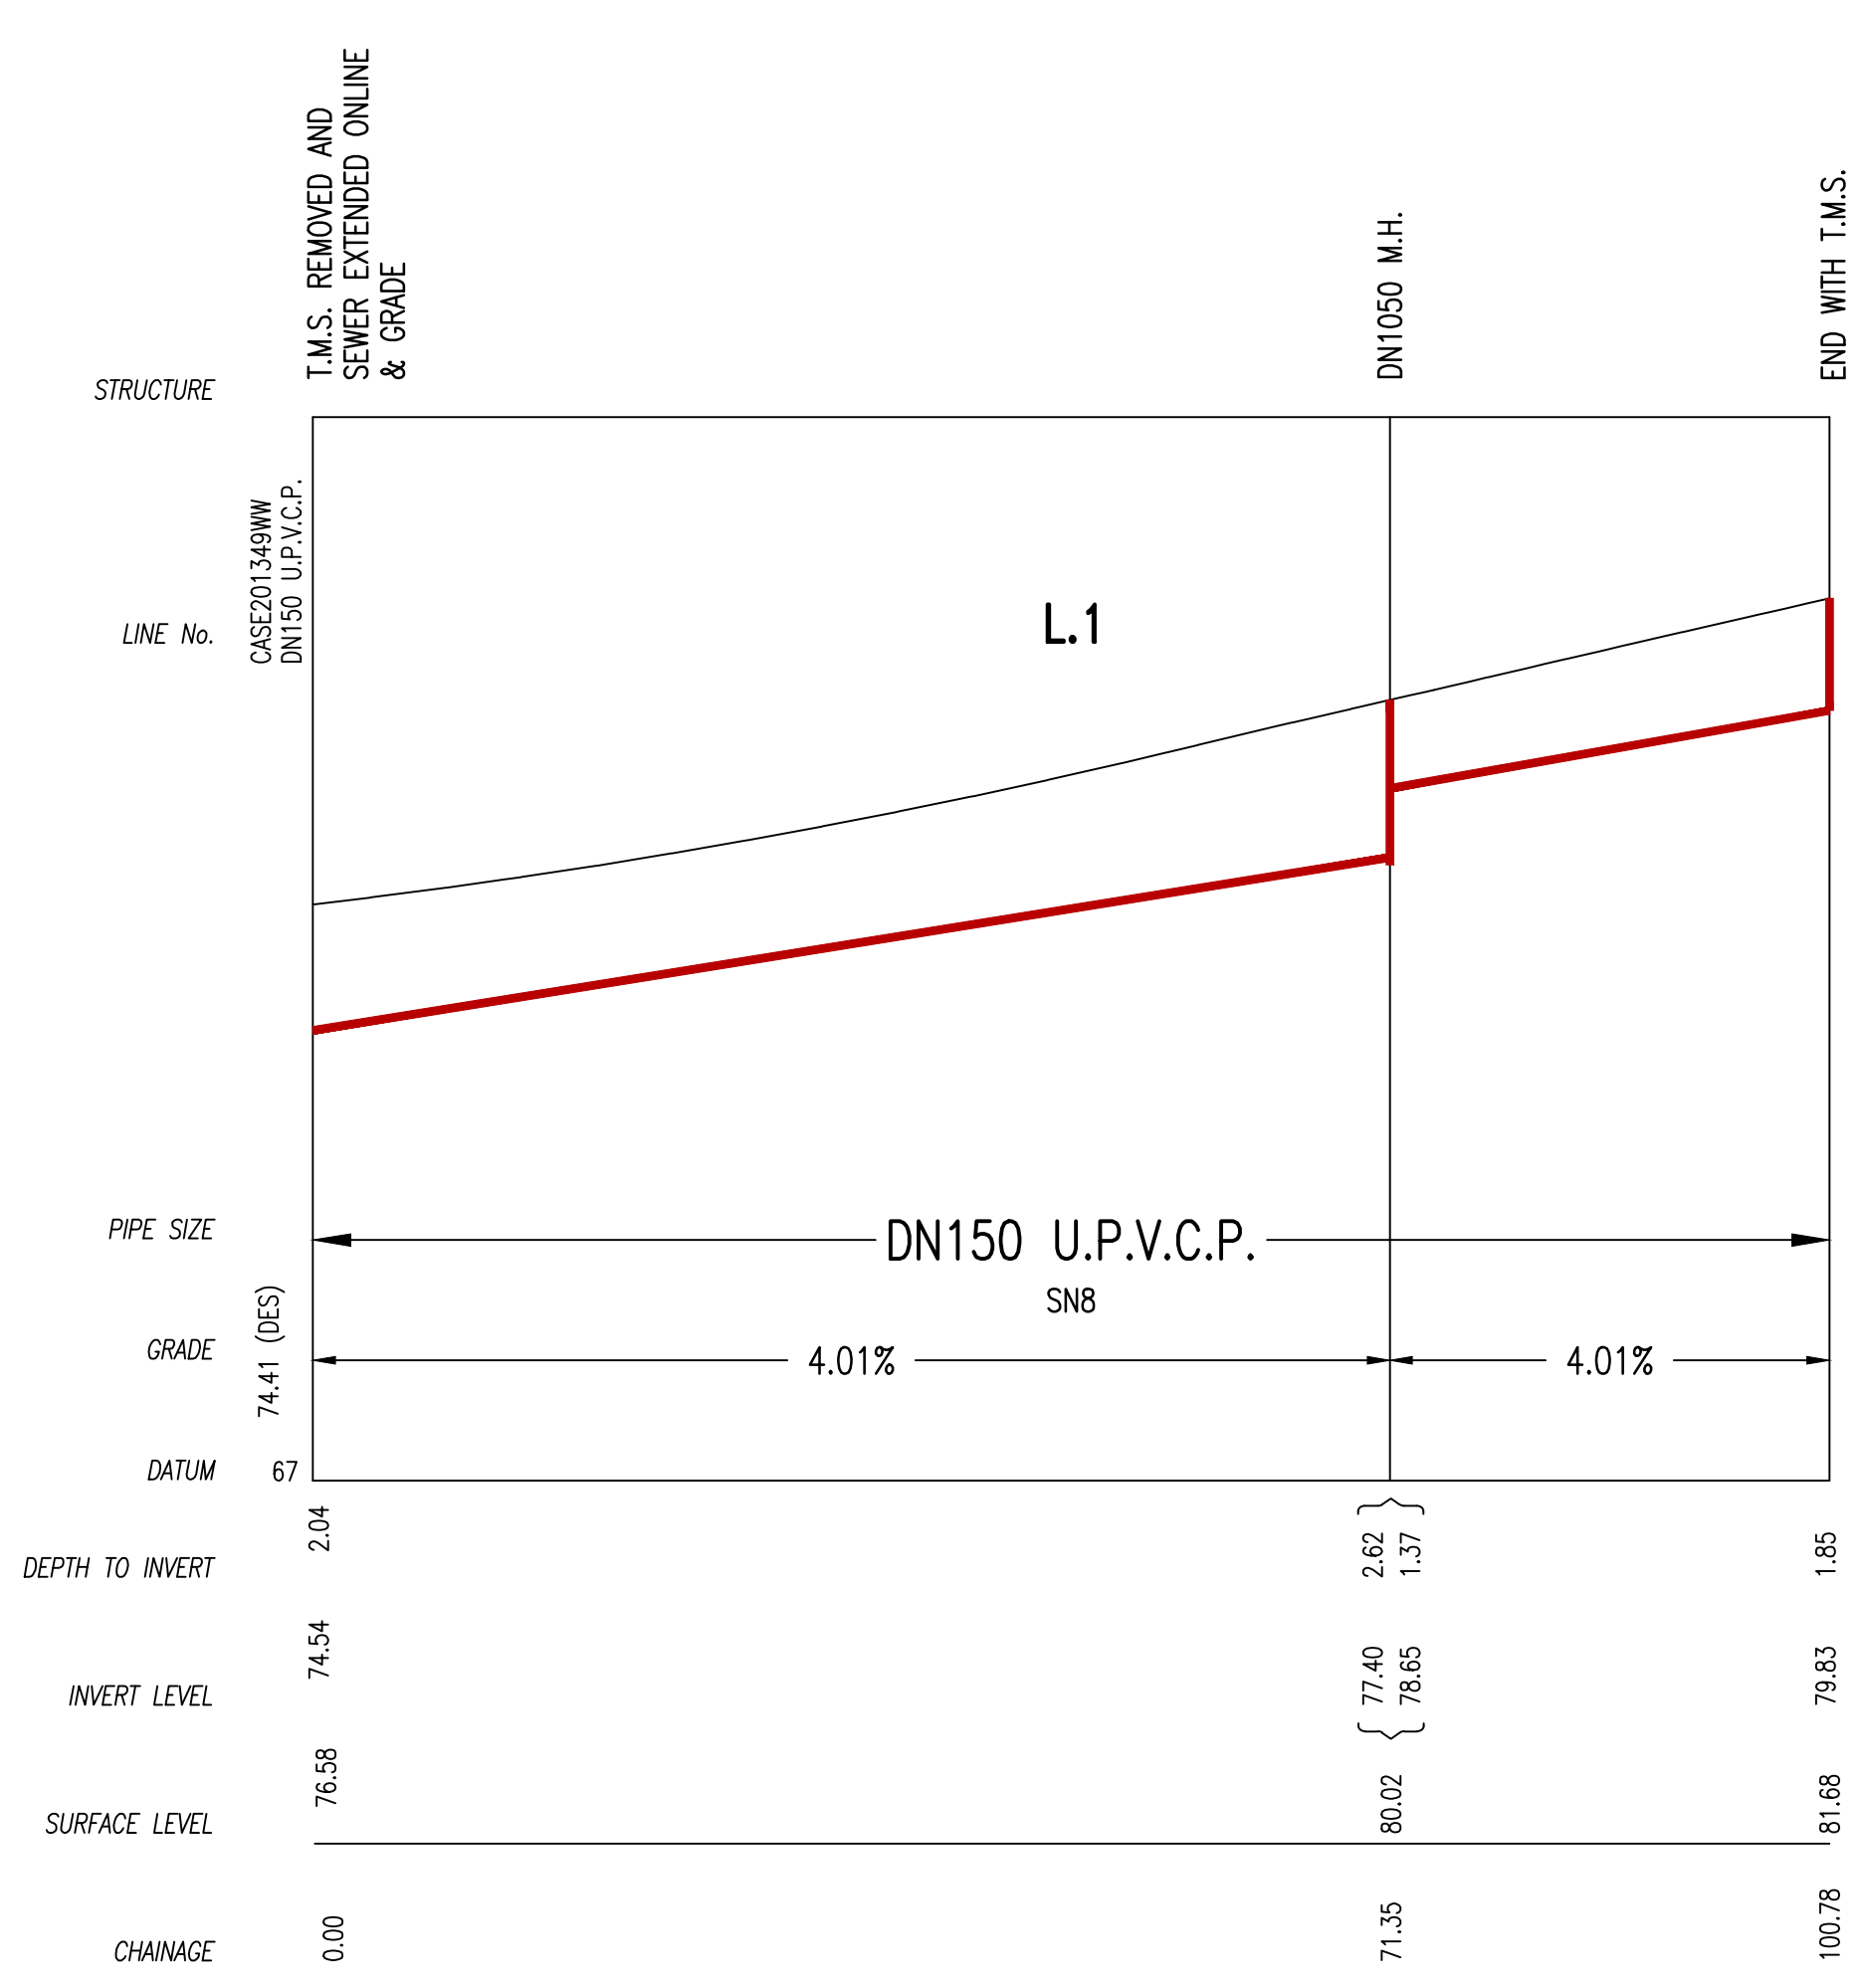


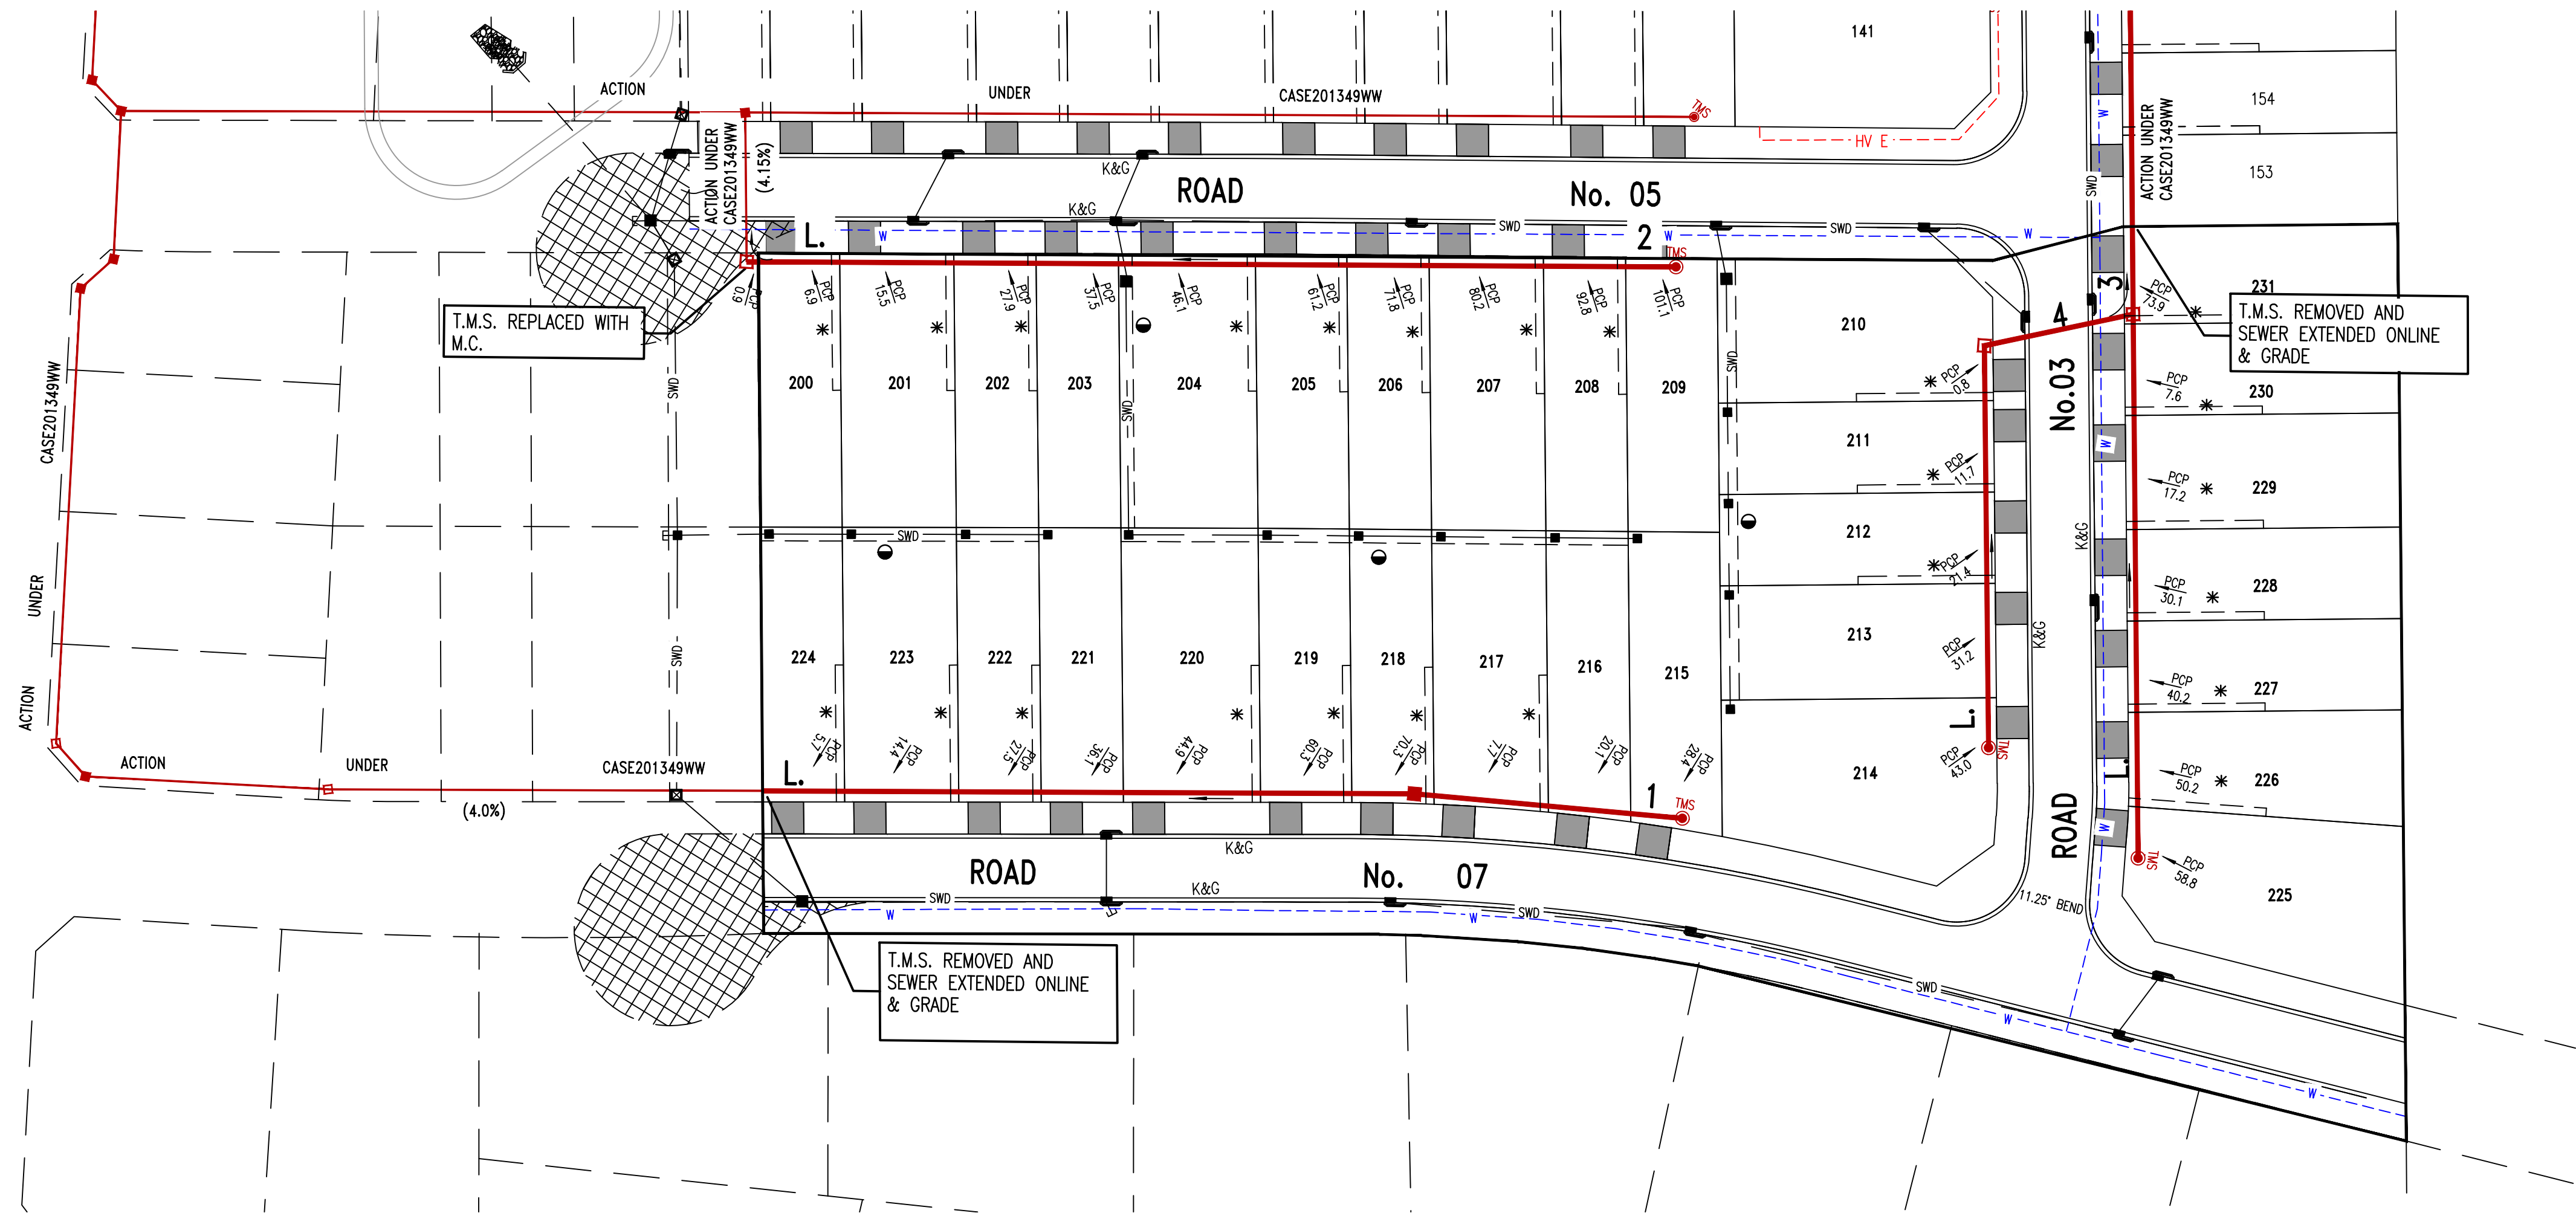

WORK AS CONSTRUCTED CERTIFICATION		Sydney WATER	
DEVELOPER	MIRAC HOMES (NSW) PTY LTD	SYDNEY WATER CORPORATION	
W.S.C.	ORION CONSULTING ENGINEERS PTY LTD	Case No. 201350WW SHT 2 OF 3 SHTS.	
CONSTRUCTOR	CAREY CONSTRUCTION PTY LTD		
COMPLETED	29/01/2024		
W.A.C. PREPARED	27/02/2024		
DESIGNER	ORION CONSULTING ENGINEERS PTY LTD	SYDNEY WATER CORPORATION	
I CERTIFY THAT THE WORKS HAVE BEEN CONSTRUCTED IN ACCORDANCE WITH THE WORK AS CONSTRUCTED DRAWINGS		FOR DETAILS OF SERVICES SEE SHEET 1	