


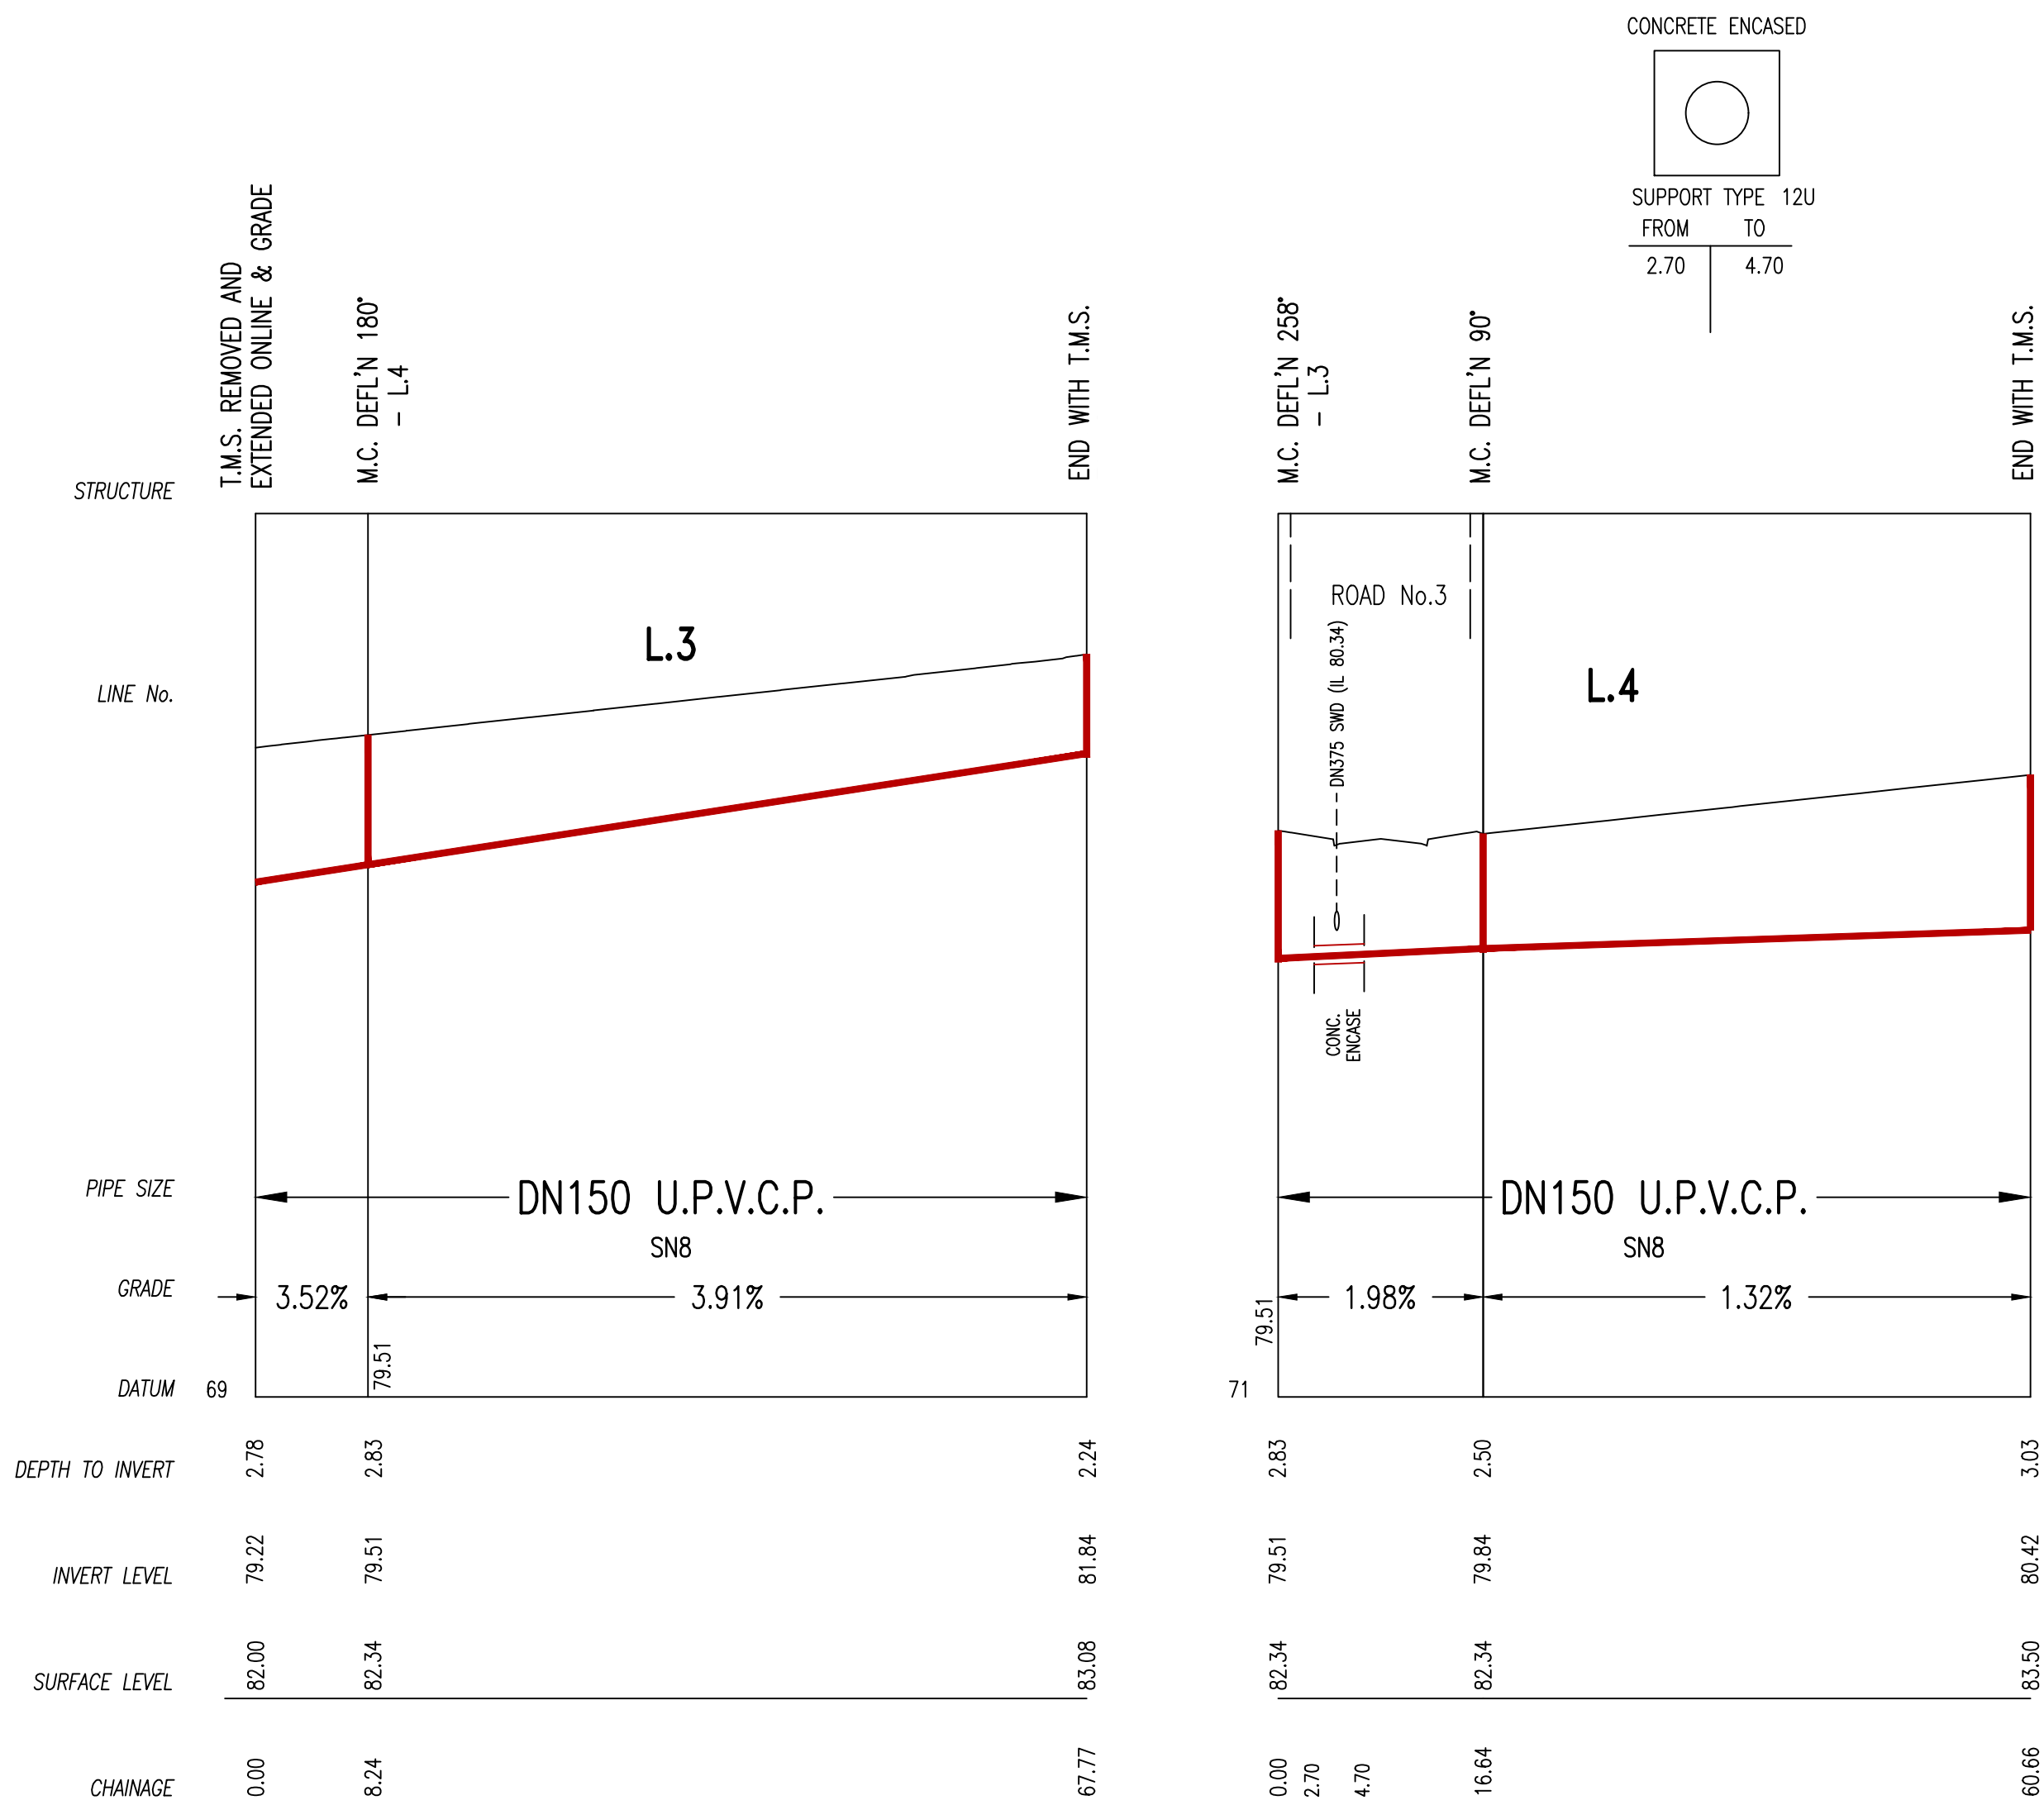

WORK AS CONSTRUCTED CERTIFICATION		Sydney WATER SYDNEY WATER CORPORATION	
DEVELOPER	MIRVAC HOMES (NSW) PTY LTD	Case No. 201350WW	SHT 3 OF 3 SHTS.
W.S.C.	ORION CONSULTING ENGINEERS PTY LTD.		
CONSTRUCTOR	CAREY CONSTRUCTION PTY LTD		
COMPLETED	29.01.2024		
W.A.C. PREPARED	27.02.2024		
DESIGNER	ORION CONSULTING ENGINEERS PTY LTD.	SYDNEY WATER CORPORATION	
I CERTIFY THAT THE WORKS HAVE BEEN CONSTRUCTED IN ACCORDANCE WITH THE WORK AS CONSTRUCTED DRAWINGS		FOR DETAILS OF SERVICES SEE SHEET 1	