


5Mpa GROUT MIX
REFER TO NOTE "A"

STEEL ENCASING PIPE OD355 BORE
6.5mm THICK

SPACER TO KEEP SEWER PIPE CENTRALLY
LOCATED (SUPPORTS TO BE SPACED 1M MAX
SPACING, AS PER SEW-1403)

DN150 PVC

TYPICAL BORE CROSS SECTION FOR DN150 SEWER PIPE
DETAIL '1'
(NOT TO SCALE)

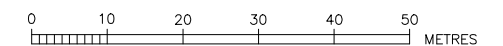

WORK AS CONSTRUCTED CERTIFICATION		Sydney WATER SYDNEY WATER CORPORATION	
DEVELOPER	MRVAC HOMES PTY LTD	Case No. 217504WW SHT 2 OF 5 SHTS.	
W.S.C.	ORION CONSULTING ENGINEERS PTY LTD		
CONSTRUCTOR	GLENNIE PARK PLUMBING & DRAINAGE		
COMPLETED	09/05/2025		
W.A.C. PREPARED	01/06/2026		
DESIGNER	IRAwad	SYDNEY WATER CORPORATION	
I CERTIFY THAT THE WORKS HAVE BEEN CONSTRUCTED IN ACCORDANCE WITH THE WORKS CONSTRUCTION DETAILS AND THE WORKS CONSTRUCTION DETAILS ARE THE SAME AS THE WORKS CONSTRUCTION DETAILS FOR DETAILS OF SERVICES SEE SHEET 1		FOR DETAILS OF SERVICES SEE SHEET 1	