
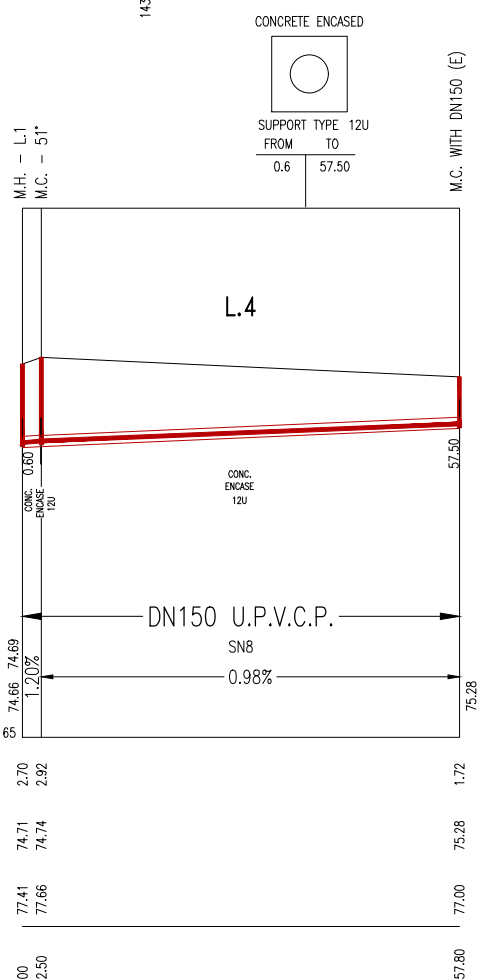
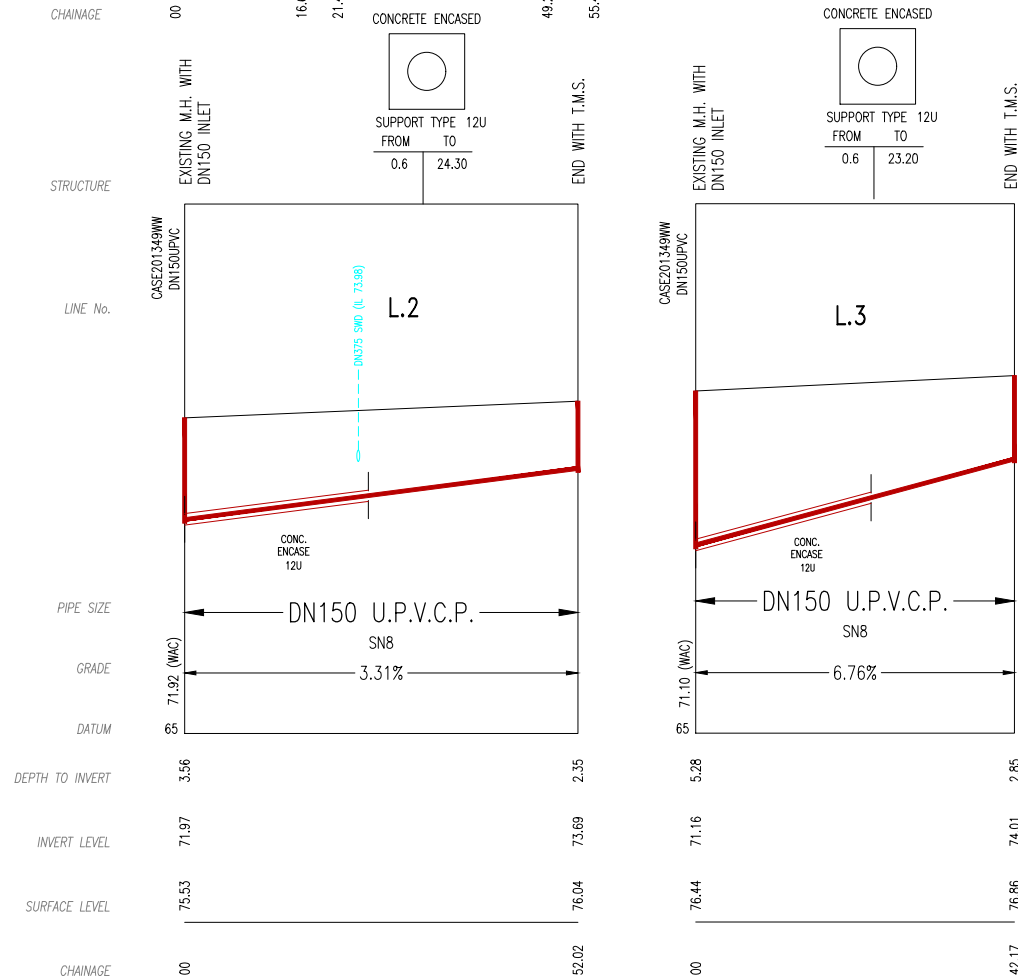


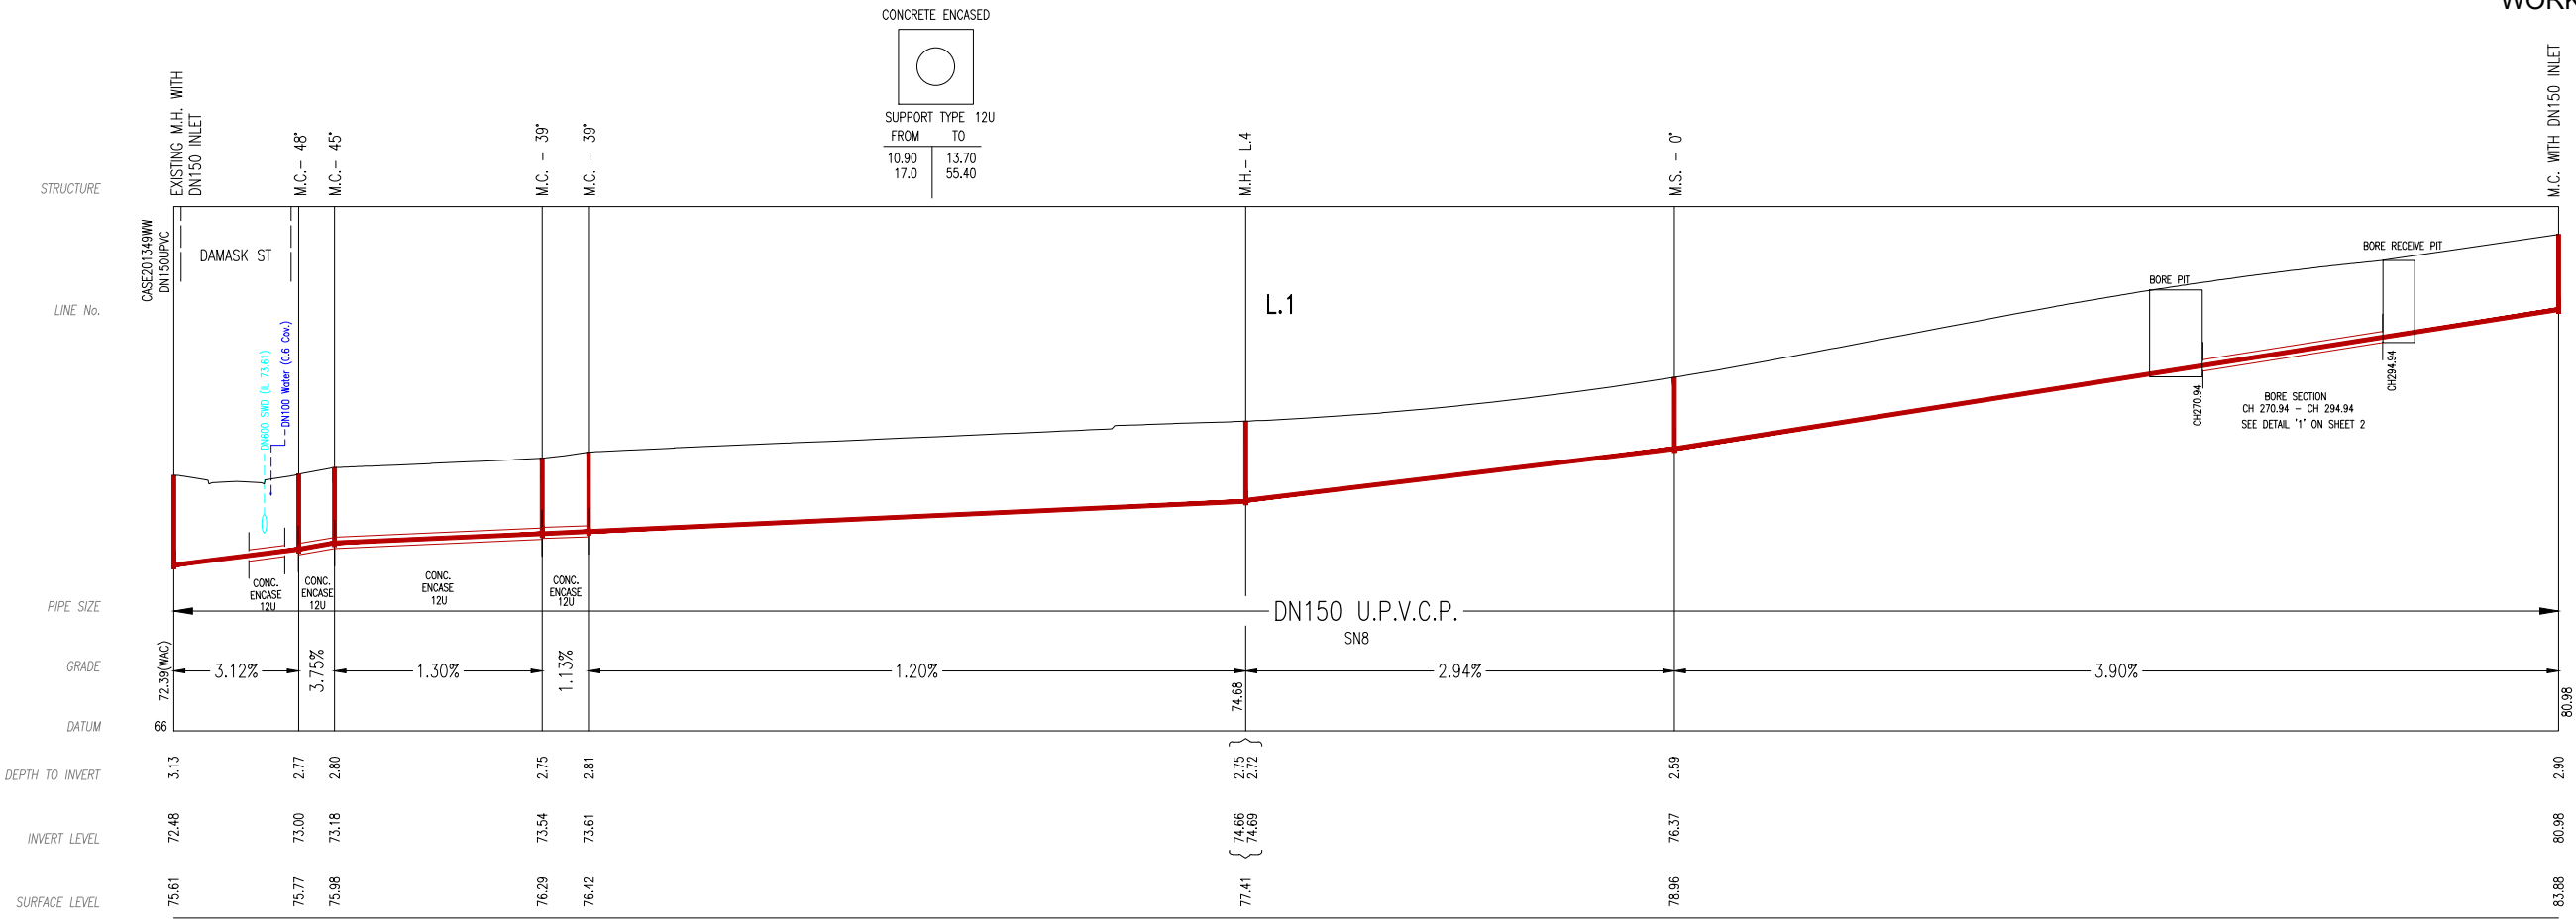

WORK AS CONSTRUCTED CERTIFICATION		SYDNEY WATER CORPORATION	
DEVELOPER	MIRVAC HOMES PTY LTD		Case No. 217504WW SHT 4 OF 5 SHTS.
W.S.C.	ORION CONSULTING ENGINEERS PTY LTD		
CONSTRUCTOR	GLENMORE PARK PLUMBING & DRAINAGE		
COMPLETED	06/05/2025		
W.A.C. PREPARED	01/08/2026		
DESIGNER	R.Awad	SYDNEY WATER CORPORATION	
I CERTIFY THAT THE WORKS HAVE BEEN CONSTRUCTED IN ACCORDANCE WITH THE WORK AS CONSTRUCTED DRAWINGS		FOR DETAILS OF SERVICES SEE SHEET 1	